Labor and Materials

1	Copper / ~~Lead~~ Connection 3/4"		$ 1.46
1	Curb Cock / ~~Valve~~ / ~~T. S. & V.~~ 3/4" in		$ 1.93
1	Service Box Old returned Short 3½ x 4½ / ~~Long 4½ x 5½~~ / Buff. or Rdway		$ 1.77
18	Ft. 3/4" in. Copper / ~~Galv Iron~~ / ~~Cast Iron~~ Pipe at 22		$ 3.96
	Nipples in. at		$
	Bushings to in. at		$
	Red'g / Inc'g Conplings to in. at		$
	Union in. at		$
	Meter in. at		$
	Lead Joints at		$
	Leadite Joints at		$
1	Hrs. Foreman at	31¼	$ .31
6	Hrs, Chauffeur at	62½	$ 3.75
	Hrs. Tapper at		$
12	Hrs. Labor at	45	$ 5.40
	Hrs. Labor at		$
	Hrs. Compressor at		$
	Compensation Ins.		$ 29
	Trucking		$ 1.00
	Builders Use of Water Patch		$ 5.00
			$
			$
			$
	Tap made By Pump		$
			$ 24.87

10 0-1937

Lawton ~~St.~~ ~~Pl.~~ Ave. No. 13

Name of Owner

Stafford

Labor and Mat'l. Report Sept 15 1937

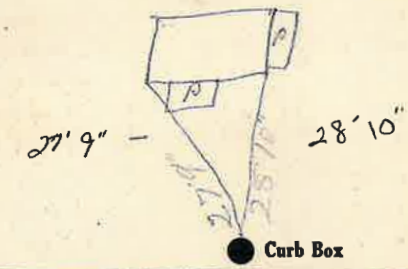

4" Main

Elev. of Main at tap 4

Gate at ● ● Gate at

TAX ID # 303.13-8-34

● Curb Box

Old tap shut off