LABOR AND MATERIALS

____ Copper / Lead } Connection ____ $ ____

____ Curb } Cock / Valve / T.S. & V. } ____ in. ____ $ ____

____ Service box / Old returned { Short 3-1/2 x 4-1/2 / Long 4-1/2 x 5-1/2 } ____ $ ____

30 Ft. 0 in. { (Copper) / G.I. / C.I. } 3/4 Pipe at ____ $ ____

____ Nipples ____ in. at ____ $ ____

____ Bushings ____ to ____ in. at ____ $ ____

____ Red'g

____ Inc'g

____ Union ____ in. at ____ $ ____

____ Meter ____ in. at ____ $ ____

____ ____ $ ____

____ Compound Joints at ____ $ ____

____ Maintenance Foreman ____ $ ____

____ Hrs. Water Maint. Man - 1 at ____ $ ____

____ Hrs. Water Maint. Man - 2 at ____ $ ____

____ Hrs. Garage Foreman ____ at ____ $ ____

____ Hrs. Labor ____ at ____ $ ____

____ Hrs. Compressor at ____ $ ____

____ ____ $ ____

____ Trucking ____ $ ____

____ Pav't Patch ____ $ ____

____ ____ $ ____

____ ____ $ ____

____ ____ $ ____

____ ____ $ ____

____ $ ____

15'-4" sewer

4 LeLand St. / Pl. / Ave. No. 4

Name of Owner WAREHOUSE BATHROOM

Labor and Mat'l. Report ~~19~~ 10/10/03

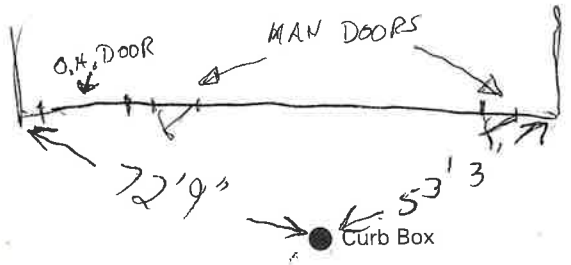

6" Main

Elev. of Main at tap 4'1"

Gate at ● ● Gate at

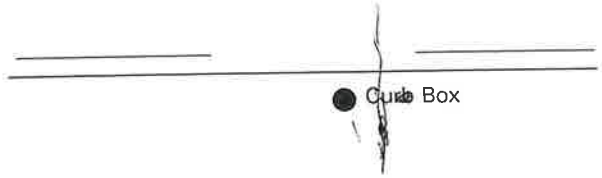

WATER LINE IS right side OF SEWER!

15 Feet Sewer 4"
1W MANHOLE