LABOR AND MATERIALS

1	Copper / ~~Lead~~ Connection	$ 1.23
1	Curb { Cock / ~~Valve~~ / ~~T. S. & V.~~ } 3/4 in.	$ 1.68
1	~~Service Box~~ Old returned { ~~Short 3½x4½~~ / Long 4½x5½ / ~~Buff. or Rdway~~ }	$ 1.75
37	Ft. 3/4 in. { Copper / ~~Galv Iron~~ / ~~Cast Iron~~ } Pipe at	$ 5.55
	Nipples ____ in. at	$
	Bushings ____ to ____ in. at	$
	Red'g / Inc'g Couplings ____ to ____ in. at	$
	Union ____ in. at	$
	Meter ____ in. at	$
	Lead Joints at	$
	Leadite Joints at	$
	Hrs. Foreman at	$
7	Hrs. Chauffeur at 62½	$ 4.37
1½	Hrs. Tapper at	$ 1.25
25	Hrs. Labor at	$ 1.75
	Hrs. Labor at	$
	Hrs. Compressor at	$
	Compensation Ins.	$ .52
	Trucking	$ 1.00
	Builders Use of Water	$
		$
		$
		$
		$ 25.60

1 0 7 - 1938

St. / ~~Pl.~~ 25

Leonard Ave. No. 14

Name of Owner

Sheehan

Labor and Mat'l. Report Aug. 16 1938

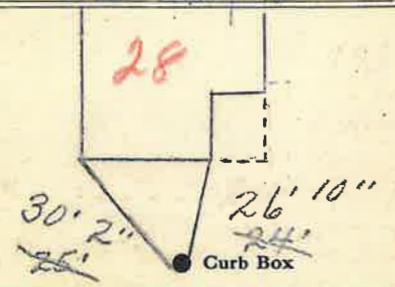

4 Main — Elev. of Main at tap 7½

Gate at ● ● Gate at

TAX ID # 303.17-13-5

● Curb Box

Old tap shut off and disconnected.

To be Billed ✓ MM