LABOR AND MATERIALS

1	Copper / Lead Connection 3/4	$ 1.35
1	Curb { Cock / Valve / T. S. & V. } 3/4 in.	$ 1.98
1	Service Box Old returned { Short 3½x4½ / Long 4½x5½ / Buff or Rdway }	$ 1.82
9	Ft. 3/4 in. { Copper / Galv Iron / Cast Iron } Pipe at 20	$ 1.80
	Nipples ..... in. at	$ .....
	Bushings ..... to ..... in. at	$ .....
	Red'g / Inc'g Couplings ..... to ..... in. at	$ .....
	Union ..... in. at	$ .....
	Meter ..... in. at	$ .....
	Lead Joints at	$ .....
	Leadite Joints at	$ .....
	Hrs. Foreman at	$ .....
5	Hrs. Chauffeur at L83 1/4	$ 3.44
11	Hrs. Tapper at	$ 7.56
14	Hrs. Labor at 50	$ 7.00
	Hrs. Labor at	$ .....
1½	Hrs. Compressor at 92	$ 1.38
	Compensation Ins.	$ .56
	Trucking	$ 1.00
	Builders Use of Water Patch	$ 5.00
	Tap 4 Hessel	$ .....
		$ .....
		$ .....
		$ .....
		$ 37.79

4 1942

St. 23
Pl.
Ave. No. 11

Leonard

Name of Owner

Donohue

Labor and Mat'l. Report Dec 23 1941

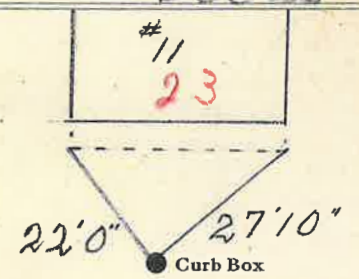

4 Main

Elev. of Main at tap 5

Gate at ● ● Gate at

TAX ID # 303.17-14-10

● Curb Box

Tobechange Billed