Labor and Materials

1 Lead Connection 3/4 ..... $
1 Curb Cock 3/4 ..... $
1 Service Box Old returned { Short 3½ x 4½ / ~~Long 4½ x 6½~~ / Buffalo } $
25 Ft. 3/4 in. ~~G. I.~~ Pipe at ~~Copper~~ ..... $
Nipples ..... in. at ..... $
1 Bushings 3/4 to 1/2 in. at ..... $
Red'g Coup ..... to ..... in. at ..... $
Inc'g Coup ..... to ..... in. at ..... $
Union ..... in. at ..... $
Meter ..... in. at ..... $
Cu. Yds. Br. Stone at ..... $
Cu. Yds. Sand at ..... $
Bags Cement at ..... $
Paving Brick { Mack / Red / Asphalt } at ..... $
2½ Hrs. Foreman at ..... $
15 Hrs. Common Labor at ..... $
Hrs. Mason at ..... $
Hrs. ..... at ..... $
Hrs. ..... at ..... $
Builders' Use of Water ..... $
..... at ..... $
..... at ..... $
..... at ..... $
..... at ..... $
Total $

15

Labor and Material Report

~~Lexington~~ Feb 11 1925

9 ~~ROBERTS~~ AVE

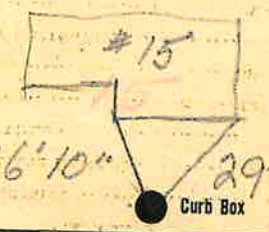

6" Main Elev. of Main at tap 7
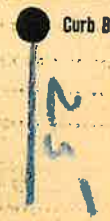
Gate at ● ● Gate at