Labor and Materials

1 Lead Connection ..... $ 3.7
1 Curb Cock ..... $ 3.7
1 Service Box { Short 3½ x 4½ / Long 4½ x 5½ / Old returned / Buffalo } ..... $
3.7 Ft. ¾ in. G.I. Pipe at Cop ..... $
Nipples ..... in. at ..... $
1 Bushings ¾ to ½ in. at ..... $
Red'g Coup ..... to ..... in. at ..... $
Inc'g Coup ..... to ..... in. at ..... $
Union ..... in. at ..... $
Meter ..... in. at ..... $
Cu. Yds. Br. Stone at ..... $
Cu. Yds. Sand at ..... $
Bags Cement at ..... $
Paving Brick { Mack / Red / Asphalt } at ..... $
2½ Hrs. Foreman at ..... $
15 Hrs. Common Labor at ..... $
Hrs. Mason at ..... $
Hrs. ..... at ..... $
Hrs. ..... at ..... $
Builders' Use of Water ..... at ..... $
..... at ..... $
..... at ..... $
..... at ..... $
10 20 2 Total $

17

Labor and Material Report Sept 11 1935


17

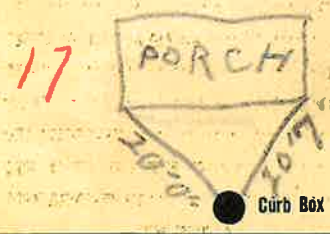

6" Main

Elev. of Main at tap 6"

Gate at

Gate at

Curb Box

1½