LABOR AND MATERIALS

Copper / Lead	Connection	$
Curb { Clock / Valve / T. S. & V. }	in.	$
Service box / Old returned	{ Short 3½X4½ / Long 4½X5½ / Buff or Rdway }	$
Ft. in.	{ Copper / Galv. Iron / Cast Iron } Pipe at	$
Nipples	in. at	$
Bushings	to in. at	$
Red'g / Inc'g	Couplings to in. at	$
Union	in. at	$
Meter	in. at	$
Lead Joints at		$
Compound Joints at		$
Hrs. Foreman at		$
Hrs. Chauffeur at		$
Hrs. Tapper at		$
Hrs. Labor at		$
Hrs. Labor at		$
Hrs. Compressor at		$
Compensation Ins.		$
Trucking		$
Builders Use of Water		$
Warsinski & Geo		$
		$
		$
		$
		$

St. 21
Pl.
Ave. No. 15

Lexington

Name of Owner

Labor and Mat'l. Report June 1945

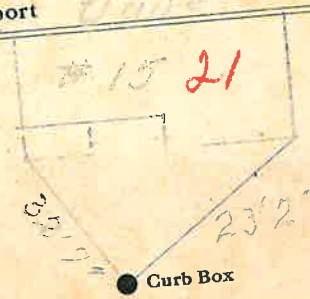

Elev. of Main at tap

Main

Gate at

Gate at

Curb Box

LSM-5C-6-1-45