Labor and Materials

1 ~~Lead~~ Connection 3/4 ..... $.....

1 Curb Cock 3/4 ..... $.....

1 Service Box { Short 3½ x 4½ / ~~Long 4½ x 5½~~ / Buffalo } ..... $.....

9 Ft. 3/4 in. ~~G.I.~~ Pipe at Cop ..... $.....

.....Nipples.....in. at ..... $.....

.....Bushings .....to..... in. at ..... $.....

1 ~~Reg~~ Coup....to....in. at STAND ..... $.....

.....Inc'g Coup....to....in. at ..... $.....

.....Union....in. at ..... $.....

.....Meter....in. at ..... $.....

.....Cu. Yds. Br. Stone at ..... $.....

.....Cu. Yds. Sand at ..... $.....

.....Bags Cement at ..... $.....

.....Paving Brick { Mack / Red / Asphalt } at ..... $.....

2 Hrs. Foreman at ..... $.....

1.3½ Hrs. Common Labor at ..... $.....

.....Hrs. Mason at ..... $.....

.....Hrs.....at..... $.....

.....Hrs.....at..... $.....

.....Builders' Use of Water ..... $.....

.....at..... $.....

.....at..... $.....

.....at..... $.....

.....at..... $.....

Total ..... $.....

Labor and Material Report 1925

22

Lexington

18 ROBERTS AVE

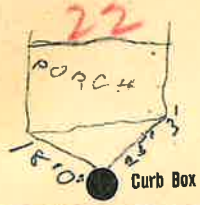

6" Main

Elev. of Main at tap 6"

Gate at ●

● Gate at

● Curb Box

19