Labor and Materials

1 ~~Lead~~ Connection ¾ ..... $
1 Curb Cock ¾ ..... $
Service Box { Short 3½ x 4½ / Long 4½ x 5½ / ~~Buffalo~~ } Old returned ..... $
12 Ft. ¾ in. G. I. Pipe at ..... $
1 Nipples ¾ in. at ..... $
Bushings ..... to ..... in. at ..... $
Red'g Coup .... to .... in. at ..... $
Inc'g Coup .... to .... in. at ..... $
Union .... in. at ..... $
Meter .... in. at ..... $
Cu. Yds. Br. Stone at ..... $
Cu. Yds. Sand at ..... $
Bags Cement at ..... $
Paving Brick { Mack / Red / Asphalt } at ..... $
13 Hrs. Foreman at ..... $
2 Hrs. Common Labor at ..... $
Hrs. Mason at ..... $
Hrs. ..... at ..... $
Hrs. ..... at ..... $
Builders' Use of Water ..... $
..... at ..... $
..... at ..... $
..... at ..... $
..... at ..... $
Total $

Labor and Material Report Dec 19 1925

30 Lexington
26 ROBERTS AVE

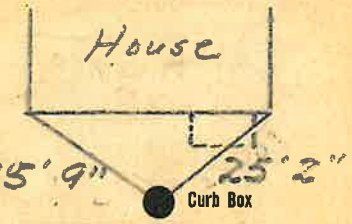

6" Main — Elev. of Main at tap 6'

Gate at ● — ● Gate at