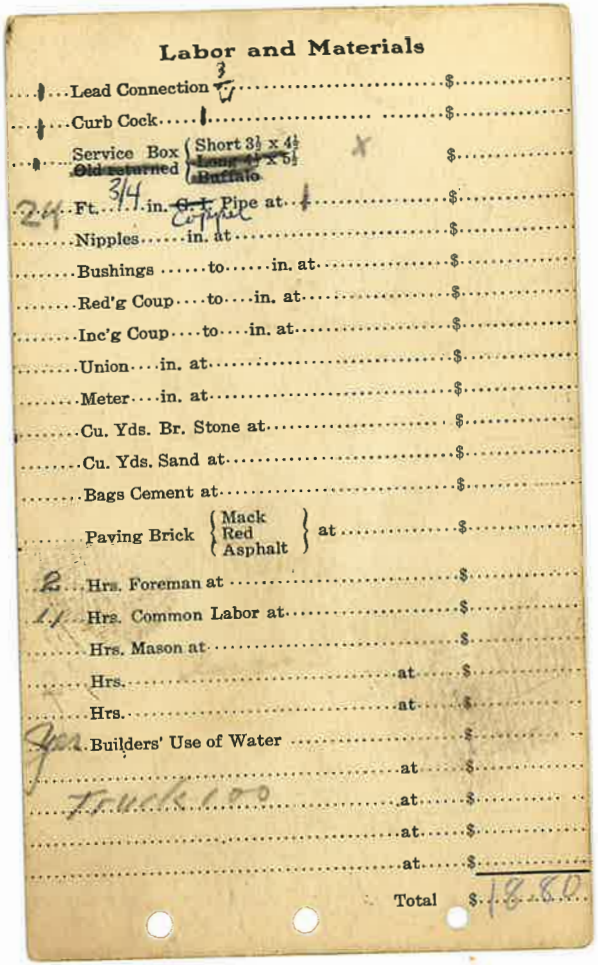

Labor and Materials

1 Lead Connection 3/4 ..... $
1 Curb Cock 1 ..... $
1 Service Box { Short 3½ x 4½ / ~~Long 4½ x 5½~~ / ~~Old returned~~ Buffalo } X ..... $
24 Ft. 3/4 in. ~~G. I.~~ Copper Pipe at 1 ..... $
Nipples ..... in. at ..... $
Bushings ..... to ..... in. at ..... $
Red'g Coup ..... to ..... in. at ..... $
Inc'g Coup ..... to ..... in. at ..... $
Union ..... in. at ..... $
Meter ..... in. at ..... $
Cu. Yds. Br. Stone at ..... $
Cu. Yds. Sand at ..... $
Bags Cement at ..... $
Paving Brick { Mack / Red / Asphalt } at ..... $
2 Hrs. Foreman at ..... $
11 Hrs. Common Labor at ..... $
Hrs. Mason at ..... $
Hrs. ..... at ..... $
Hrs. ..... at ..... $
400 Builders' Use of Water ..... $
Truck 100 ..... at ..... $
..... at ..... $
..... at ..... $
..... at ..... $
Total $ 18.80

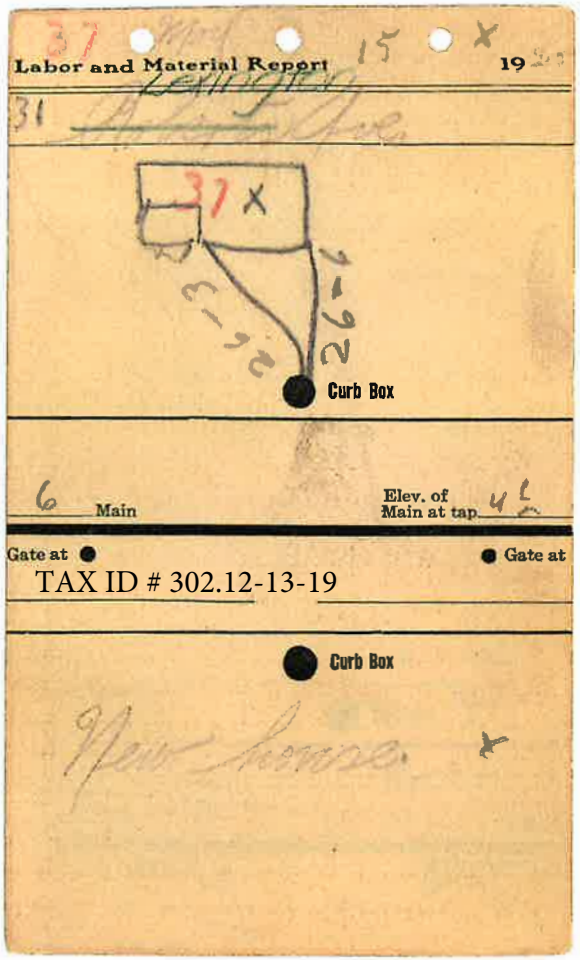

Labor and Material Report 15 X 19

31 Lexington Ave.

37 X

Curb Box

6 Main

Elev. of Main at tap 4 ft

Gate at ● ● Gate at

TAX ID # 302.12-13-19

Curb Box

New house. X

5/8/2023 main to valve replaced with plastic. no gooseneck - removed. Valve to house galvanized.