Labor and Materials

1	Lead Connection	$
1	Curb Cock	$
1	Service Box ~~Old returned~~ { Short 3½ x 4½ / ~~Long 4½ x 5½~~ / ~~Buffalo~~ }	$
7	Ft. ... in. G. I. Pipe at	$
	Nipples ... in. at	$
	Bushings ... to ... in. at	$
	Red'g Coup ... to ... in. at	$
	Inc'g Coup ... to ... in. at	$
	Union ... in. at	$
	Meter ... in. at	$
	Cu. Yds. Br. Stone at	$
	Cu. Yds. Sand at	$
	Bags Cement at	$
	Paving Brick { Mack / Red / Asphalt } at	$
3	Hrs. Foreman at	$
14	Hrs. Common Labor at	$
	Hrs. Mason at	$
	Hrs. ... at	$
	Hrs. ... at	$
Jr.	Builders' Use of Water	$
	... at	$
	Truck 100 ... at	$
	... at	$
	... at	$
	Total	$ 17.38

~~34~~ Dec. 19 24

Labor and Material Report

~~34~~ Roberts Ave.

42

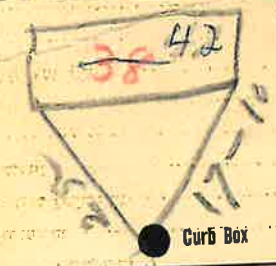

6 Main

Elev. of Main at tap 5

Gate at

Gate at

Curb Box