LABOR AND MATERIALS

1	Copper ~~Lead~~	Connection	3/4	$ 2.90
1	Curb { Clock / ~~Valve~~ / ~~T. S. & V.~~ }		3/4 in.	$ 3.60
1	Service box ~~Old returned~~	{ Short 3½X4½ / Long 4½X5½ / Buff or Rdway }		$ 5.80
10 8	Ft. 3/4 in.	{ Copper / Galv. Iron / Cast Iron }	Pipe at 35	$ 2.80
	Nipples	in. at		$
	Bushings	to	in. at	$
	Red'g / Inc'g Couplings	to	in. at	$
1	Union 3/4 in.	at (Couplings Cop to Cap)		$
	Meter	in. at		$
	Lead Joints at			$
	Compound Joints at			$
	Hrs. Foreman at			$
	Hrs. Chauffeur at			$
3	Hrs. Tapper at	91		$ 2.73
10	Hrs. Labor at	80		$ 8.00
	Hrs. Labor at			$
	Hrs. Compressor at			$
	Compensation Ins.			$ .24
	Trucking			$ 1.—
	Builders Use of Water			$ 5.80
	Tap & Machine			$
				$
				$
				$
				$ 32.77

127 + 47

St. 547
Pl.
Lexington Ave. No. 56

Name of Owner Geneva Eddy.

~~Corbin Lyman~~

Labor and Mat'l. Report Sept 9 1917

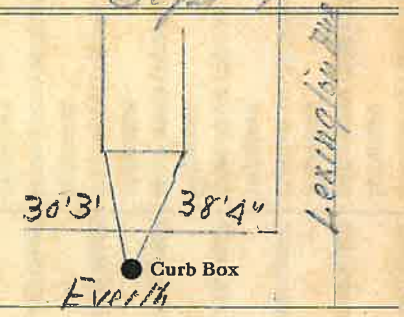

5 Main

Elev. of Main at tap 5'

Gate at ● ● Gate at

● Curb Box

LSM-5C-6-1-45