LABOR AND MATERIALS

Copper / Lead } Connection _____ $_____

Curb { Cock / Valve / T. S. & V. } _____ in. _____ $_____

Service box / Old returned { Short 3½ x 4½ / Long 4½ x 5½ / Buff or Rdway } _____ $_____

11 Ft. 6 in. { Copper / ~~G. I.~~ / C. I. } Pipe at 3/4 $_____

Nipples _____ in. at _____ $_____

Bushings _____ to _____ in. at _____ $_____

Red'g / Inc'g } Coupl'gs _____ to _____ in. at _____ $_____

Union _____ in. at _____ $_____

Meter _____ in. at _____ $_____

Lead Joints at _____ $_____

Compound Joints at _____ $_____

Maintenance Foreman _____ $_____

Hrs. Water Maint. Man—1 at _____ $_____

Hrs. Water Maint. Man—2 at _____ $_____

Hrs. Garage Foreman _____ at _____ $_____

Hrs. Labor— _____ at _____ $_____

Hrs. Compressor at _____ $_____

Compensation Ins. at $_____ per C _____ $_____

Trucking _____ $_____

Pav't Patch _____ $_____

_____ $_____

Tap by Tracem + C. $_____

_____ $_____

O'head _____ $_____

$_____

St. / Pl. / Ave. LEXINGTON No. 12

Name of Owner

Charles Dunn

Labor and Mat'l. Report Aug 19 19 77

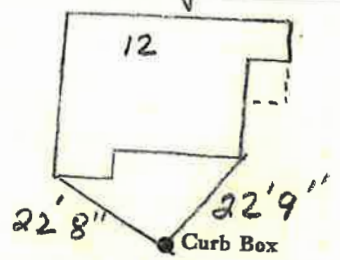

6" Main Elev. of Main at tap 9'

Gate at ● ● Gate at

TAX ID # 302.12-10-22

● Curb Box

LSM—5C—6-1-67