Labor and Materials

1	Copper ~~Lead~~ Connection	3/4"	$ 2.71
1	Curb ~~Cock~~ ~~Valve~~ ~~T. S. & V.~~	3/4" in	$ 3.83
1	Service Box 4' x 5' Old returned ~~Short 3½ x 4½~~ ~~Long 4½ x 5½~~ ~~Buff. or Rdway~~	Medium	$ 4.69
12 Ft.	3/4 in. ~~Copper~~ ~~Galv. Iron~~ ~~Cast Iron~~	Pipe at 45	$ 5.40
	Nipples in. at		$
	Bushings to in. at		$
	Red'g Inc'g Couplings to in. at		$
	Union in. at		$
	Meter in. at		$
	Lead Joints at		$ 4.94
	Leadite Joints at		$
4	Hrs. Foreman at	1.51	$ 6.04
9	Hrs. ~~Chauffeur~~ at Dump 2	1.24	$ 11.16
	Hrs. Tapper at		$
28	Hrs. Labor at	1.13	$ 31.64
	Hrs. Labor at		$
2	Hrs. Compressor at	1.50	$ 3.00
	Compensation Ins.	4.29	$ 2.10
	Trucking		$ 1.50
	Builders Use of Water Patch		$ 10.80
Tap by Gissard 12-9-54			$
			$
			$
			$
			$ 87.87

Liberty St. / Pl. / Ave. No. 2

Name of Owner

Chas. Potter

Labor and Mat'l. Report Dec. 9 1954

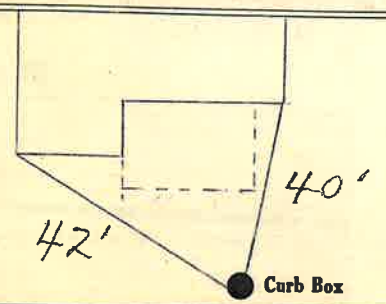

1" Main

Elev. of Main at tap 5'

Gate at •

• Gate at

● Curb Box