LABOR AND MATERIALS

1	Copper Lead } Connection	3/4	$ 1.78
1	Curb { Clock Valve T. S. & V. }	3/4 in.	$ 2.61
Some	Service box Old returned { Short 3⅛X4⅛ Long 4⅛X5⅛ Buff or Rdway }		$
10	Ft. 3/4 in. { Copper Galv. Iron Cast Iron } Pipe at 23		$ 2.30
	Nipples in. in. at		$
	Bushings to in. at		$
	Red'g Inc'g } Couplings to in. at		$
	Union in. at		$
	Meter in. at		$
	Lead Joints at		$
	Compound Joints at		$
	Hrs. Foreman at		$
	Hrs. Chauffeur at		$
9	Hrs. Tapper at .75		$ 6.75
1.5	Hrs. Labor at .65		$ 9.75
	Hrs. Labor at		$
	Hrs. Compressor at		$
	Compensation Ins.		$ .45
	Trucking		$ 1.—
	Builders Use of Water		$ 5.00
Tap by Magnuson			$
			$
			$
			$
			$ 29.64

✓

35-46

✓

In basin

St.
Pl.
Ave. No. 6

Name of Owner

Hoy

Labor and Mat'l. Report June 11 1946

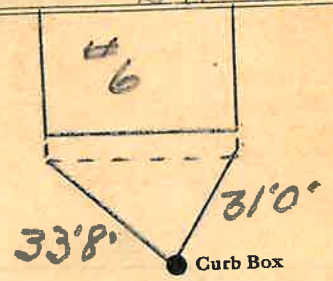

6 Main

Elev. of Main at tap 5—

Gate at ●

● Gate at

● Curb Box

LSM-5C-6-1-45