Labor and Materials

1 Lead Connection 3/4 ..... $.....

1 Curb Cock ..... $.....

1 Service Box { Short 3½ x 4½ / ~~Long 4½ x 5½~~ / Buffalo } ..... $.....

37 Ft. ..... in. G. I. Pipe at 1 ..... $.....

Nipples ..... in. at ..... $.....

Bushings ..... to ..... in. at ..... $.....

Red'g Coup .... to .... in. at ..... $.....

Inc'g Coup .... to .... in. at ..... $.....

Union .... in. at ..... $.....

Meter .... in. at ..... $.....

Cu. Yds. Br. Stone at ..... $.....

Cu. Yds. Sand at ..... $.....

Bags Cement at ..... $.....

Paving Brick { Mack / Red / Asphalt } at ..... $.....

3 Hrs. Foreman at ..... $.....

7 Hrs. Common Labor at ..... $.....

Hrs. Mason at ..... $.....

Hrs. ..... at ..... $.....

Hrs. ..... at ..... $.....

gm Builders' Use of Water ..... $.....

..... at ..... $.....

Trucks 1.00 ..... at ..... $.....

..... at ..... $.....

..... at ..... $.....

Total $ 17.53

June 10

Labor and Material Report 1924

1 Tap

No measurement

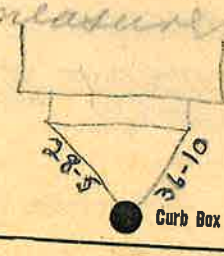

16 Main

Elev. of Main at tap 4

Gate at ●

● Gate at

● Curb Box