LABOR AND MATERIALS

1	Copper / ~~Lead~~ Connection	3/4	$ 1.23
1	Curb Cock / ~~Valve~~ / ~~T. S. & V.~~	3/4 in.	$ 1.68
1	Service Box Old returned Short 3½x4½ / ~~Long 4½x5½~~ / ~~Buff. or Rdway~~		$ 1.75
8	Ft. 3/4 in. Copper / ~~Galv Iron~~ / ~~Cast Iron~~ Pipe at		$ 1.20
	Nipples ____ in. at		$
	Bushings ____ to ____ in. at		$
	Red'g / Inc'g Couplings ____ to ____ in. at		$
	Union ____ in. at		$
	Meter ____ in. at		$
	Lead Joints at		$
	Leadite Joints at		$
	Hrs. Foreman at		$
1	Hrs. Chauffeur at	62½	$ 63
3½	Hrs. Tapper at		$ 2.19
22	Hrs. Labor at		$ 9.90
	Hrs. Labor at		$
1	Hrs. Compressor at	87½	$ .88
	Compensation Ins.		$ .39
	Trucking		$ 1.—
	Builders Use of Water	no patch (BP)	$
	Taply Hassell		$
			$
			$
			$
			$ 20.85

113 - 1938

St.
Pl.
Lincoln Ave. No. 9

Name of Owner
Jas B Tidman

Labor and Mat'l. Report Sept 1 193

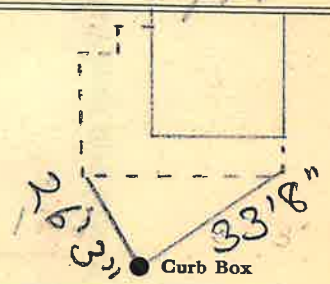

14 Main

Elev. of Main at tap 4½

Gate at ●

● Gate at

● Curb Box

Old Shut off