LABOR AND MATERIALS

1	Copper / ~~Lead~~ Connection	3/4	$ 1.23
1	Curb { Cock / ~~Valve~~ / ~~T. S. & V.~~ }	3/4 in.	$ 1.68
1	Service Box Old returned { Short 3½x4½ / Long 4½x5½ / ~~Buff. or Rdway~~ }		$ 1.75
7	Ft. 3/4 in. { Copper / ~~Galv Iron~~ / ~~Cast Iron~~ } Pipe at		$ 1.05
	Nipples ____ in. at		$
	Bushings ____ to ____ in. at		$
	Red'g / Inc'g Couplings ____ to ____ in. at		$
	Union ____ in. at		$
	Meter ____ in. at		$
	Lead Joints at		$
	Leadite Joints at		$
	Hrs. Foreman at		$
2	Hrs. Chauffeur at	62½¢	$ 1.25
3	Hrs. Tapper at		$ 1.88
18	Hrs. Labor at	45	$ 8.10
	Hrs. Labor at		$
1	Hrs. Compressor at	87½¢	$ .88
	Compensation Ins.		$ .35
	Trucking		$ 1.00
	Builders Use of Water Hopatch (B.P.)		$
	Tapped Wessell		$
			$
			$
			$
			$ 19.17

1 1 4 - 1938

St.
Pl.
Lincoln Ave. No. 10

Name of Owner

T I Henning

Labor and Mat'l. Report Sept 1 19 38

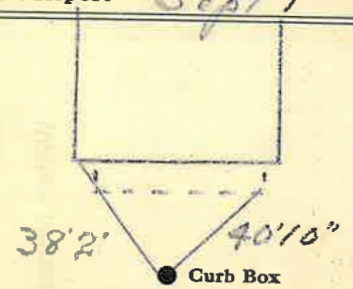

14 Main

Elev. of Main at tap 4'

Gate at ● ● Gate at

TAX ID # 302.15-14-13

● Curb Box

dr 1 Sept 1 38