Labor and Materials

1	Copper / ~~Lead~~ Connection	3/4"	$ 1.46
1	Curb — Cock / Valve / T. S. & V.	3/4" in	$ 1.93
1	Service Box — ~~Old returned~~ — Short 3½ x 4½ / Long ~~4½ x 5½~~ / ~~Buff. or Rdway~~		$ 1.77
27	Ft. 3/4 in. — Copper / ~~Galv. Iron~~ / ~~Cast Iron~~ Pipe at		$ 8.14
	Nipples ..... in. at		$
	Bushings ..... to ..... in. at		$
	Red'g / Inc'g Couplings ..... to ..... in. at		$
	Union ..... in. at		$
	Meter ..... in. at		$
	Lead Joints at		$
	Leadite Joints at		$
1	Hrs. Foreman at	2.14	$ .21
6	Hrs. Chauffeur at	62½	$ 3.75
10	Hrs. Tapper at	62½	$ 6.25
10	Hrs. Labor at	45	$ 6.25
	Hrs. Labor at		$
	Hrs. Compressor at		$
	Compensation Ins.		$ .51
	Trucking		$ 1.00
	Builders Use of Water	Patch-	$ 5.00
			$
			$
			$
			$
			$ 36.37

5-1937

St. Pl. Ave. No. 11

Laurel

Name of Owner

Dan Ennis

Labor and Mat'l. Report No. 1 19

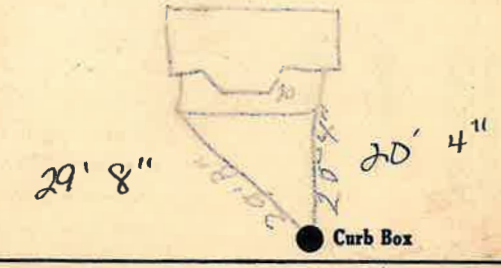

16 Main

Elev. of Main at tap 3'0"

Gate at ● ● Gate at

TAX ID # 302.15-12-30

● Curb Box

old shut off