LABOR AND MATERIALS

1	Copper / ~~Lead~~ Connection	3/4	$ 1.23
1	Curb Cock / ~~Valve~~ / ~~T. S. & V.~~	3/4 in.	$ 1.68
1	Service Box Old returned Short 3½x4½ / ~~Long 4½x5½~~ / ~~Buff. or Rdway~~		$ 1.75
9	Ft. 3/4 in. Copper / ~~Galv Iron~~ / ~~Cast Iron~~ Pipe at 15		$ 1.35
	Nipples ____ in. at		$
	Bushings ____ to ____ in. at		$
	Red'g / Inc'g Couplings ____ to ____ in. at		$
	Union ____ in. at		$
	Meter ____ in. at		$
	Lead Joints at		$
	Leadite Joints at		$
	Hrs. Foreman at		$
2	Hrs. Chauffeur at	62½	$ 1.25
3	Hrs. Tapper at	"	$ 1.88
18	Hrs. Labor at	45	$ 8.10
	Hrs. Labor at		$
1	Hrs. Compressor at	87½	$ 88
	Compensation Ins.		$ 35
	Trucking		$ 1.—
	Builders Use of Water	no patch (BP)	$
	Taplay Hessell		$
			$
			$
			$
			$ 19.47

1 1 5 - 1938

~~St.~~ ~~Pl.~~

Lincoln Ave. No. 12

Name of Owner

G. P. Crawford

Labor and Mat'l. Report Sept 1 1938

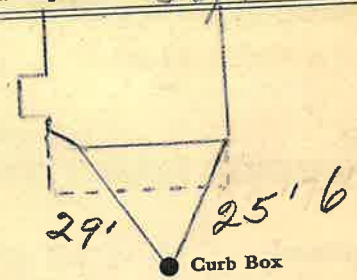

19 Main

Elev. of Main at tap 4½

Gate at ●

● Gate at

● Curb Box

old Top Street 84