LABOR AND MATERIALS

1	Copper ~~Lead~~ Connection	3/4	$ 1.23
1	Curb { Cock, Valve, T. S. & V. }	3/4 in.	$ 1.68
1	Service Box Old returned { Short 3½x4½, Long 4½x5½, Buff. or Rdway }		$ 1.75
9	Ft. 3/4 in. { Copper, ~~Galv Iron~~, ~~Cast Iron~~ } Pipe at		$ 1.35
	Nipples ____ in. at		$
	Bushings ____ to ____ in. at		$
	Red'g Inc'g Couplings ____ to ____ in. at		$
	Union ____ in. at		$
	Meter ____ in. at		$
	Lead Joints at		$
	Leadite Joints at		$
	Hrs. Foreman at		$
2	Hrs. Chauffeur at	62½	$ 1.25
3	Hrs. Tapper at	"	$ 1.88
18	Hrs. Labor at	45	$ 8.10
	Hrs. Labor at		$
1	Hrs. Compressor at	87½	$ .88
	Compensation Ins.		$ 1.35
	Trucking		$ 1.—
	Builders Use of Water	no permit (N.F.)	$
	Tap by Harrell		$
			$
			$
			$ 19.47

1 1 6 - 1938

~~St.~~ ~~Pl.~~ Lincoln Ave. No. 18

Name of Owner

F L Anderson

Labor and Mat'l. Report Sept / 19 38

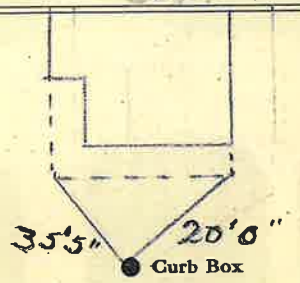

14 Main

Elev. of Main at tap 41

Gate at ● ● Gate at

● Curb Box

NEW SEWER LATERAL 9-12-2002
FROM CURB TO MAIN
LINE RUNS UNDER GAS LINE
AT CURB.
KH 9-12-2002

old Tap Sheet