LABOR AND MATERIALS

1	Copper / ~~Lead~~ Connection	3/4	$ 1.23
1	Curb Cock / ~~Valve~~ / ~~T. S. &~~ V.	3/4 in.	$ 1.68
1	Service Box Old returned Short 3½x4½ / ~~Long 4½x5½~~ / ~~Buff. or Rdway~~		$ 1.75
37	Ft. 3/4 in. Copper / ~~Galv Iron~~ / ~~Cast Iron~~ Pipe at 15		$ 5.55
	Nipples in. at		$
	Bushings to in. at		$
	Red'g / Inc'g Couplings to in. at		$
	Union in. at		$
	Meter in. at		$
	Lead Joints at		$
	Leadite Joints at		$
	Hrs. Foreman at		$
2	Hrs. Chauffeur at	62½	$ 1.25
3	Hrs. Tapper at	–	$ 1.88
18	Hrs. Labor at	45	$ 8.10
	Hrs. Labor at		$
1	Hrs. Compressor at	87½	$ .88
	Compensation Ins.		$ 35
	Trucking		$ 1.—
	Builders Use of Water	No patch (B7)	$
	Tap by Hassell		$
			$
			$
			$
			$ 23.67

1 1 1 - 1938

~~St.~~ ~~Pl.~~

LINCOLN Ave. No. 1

Name of Owner

T. O'CONNOR

Labor and Mat'l. Report 8/26-38 19

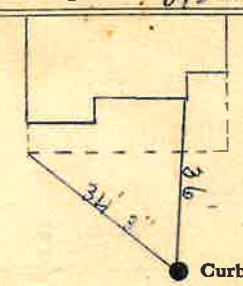

14 Main

Elev. of Main at tap 4'

Gate at ● ● Gate at

● Curb Box

Old Tap shut off