LABOR AND MATERIALS

1	Copper / ~~Lead~~ Connection	3/4	$ 1.23
1	Curb { Cock / ~~Valve~~ / ~~T. S. & V.~~ }	3/4 in.	$ 1.68
1	Service Box Old returned { Short 3½x4½ / ~~Long 4½x5½~~ / ~~Buff. or Rdway~~ }		$ 1.75
38	Ft. 3/4 in. { Copper / ~~Galv Iron~~ / ~~Cast Iron~~ } Pipe at 15		$ 5.70
	Nipples ____ in. at		$
1	Bushings 3/4 to 1/2 in. at		$ .03
	Red'g / Inc'g } Couplings ____ to ____ in. at		$
	Union ____ in. at		$
	Meter ____ in. at		$
	Lead Joints at		$
	Leadite Joints at		$
	Hrs. Foreman at		$
2	Hrs. Chauffeur at	62½	$ 1.25
3	Hrs. Tapper at	7	$ 1.88
18	Hrs. Labor at	45	$ 8.10
	Hrs. Labor at		$
1	Hrs. Compressor at	87½	$ .88
	Compensation Ins.		$ .35
	Trucking		$ 1 —
	Builders Use of Water	no patch (B.P.)	$ —
	Tap by Hewell		$
			$
			$
			$
			$ 23.85

1 2 0 - 1938

~~St.~~ ~~Pl.~~ LINCOLN Ave. No. 27

Name of Owner

GLENS FALLS REALTY CORP.

Labor and Mat'l. Report 8/26-38 19

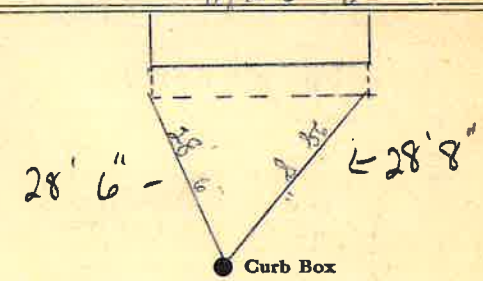

14 Main

Elev. of Main at tap 4'

Gate at ● ● Gate at

38' to MAIN

● Curb Box

Old Tap Shut Off