LABOR AND MATERIALS

1	Copper ~~Lead~~ Connection	3/4	$ 1.23
1	Curb Cock ~~Valve~~ ~~T. S. &~~ V.	3/4 in.	$ 1.68
1	Service Box Old returned Short 3½x4½ ~~Long 4½x5½~~ Buff. or Rdway		$ 1.75
39	Ft. 3/4 in. Copper ~~Galv Iron~~ Cast Iron Pipe at	15	$ 5.85
	Nipples in. at		$
1	Bushings 3/4 to 1/2 in. at		$ .03
	Red'g Inc'g Couplings to in. at		$
	Union in. at		$
	Meter in. at		$
	Lead Joints at		$
	Leadite Joints at		$
	Hrs. Foreman at		$
2	Hrs. Chauffeur at	62½	$ 1.25
3	Hrs. Tapper at	"	$ 1.88
18	Hrs. Labor at	45	$ 8.10
	Hrs. Labor at		$
1	Hrs. Compressor at	87½	$ .88
	Compensation Ins.		$ .35
	Trucking		$ 1.—
	Builders Use of Water	hopatch (B.P.)	$ —
Tap by Herrell			$
			$
			$
			$
			$ 24.00

1 2 1 - 1938

~~St.~~ ~~Pl.~~

LINCOLN Ave. No. 29

Name of Owner

E.A. BESWICK

Labor and Mat'l. Report 8/26-38 19

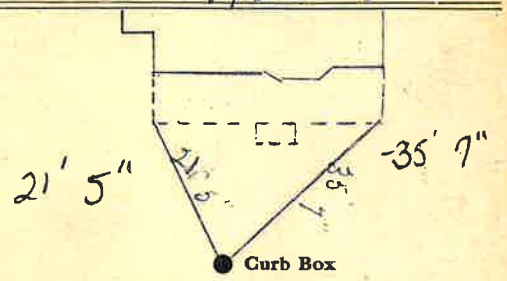

14 Main

Elev. of Main at tap 4'

Gate at ● ● Gate at

● Curb Box

Old Tap Shut Off