LABOR AND MATERIALS

1 Copper ~~Lead~~ Connection 3/4		$ 1.23
1 Curb Cock ~~Valve~~ ~~T. S. & V.~~ 3/4 in.		$ 1.68
1 Service Box Old returned Short 3½x4½ ~~Long 4½x5½~~ Buff. or Rdway		$ 1.75
13 Ft. 3/4 in. Copper ~~Galv Iron~~ Cast Iron Pipe at		$ 1.95
Nipples in. at		$
Bushings to in. at		$
Red'g Inc'g Couplings to in. at		$
Union in. at		$
Meter in. at		$
Lead Joints at		$
Leadite Joints at		$
Hrs. Foreman at		$
2 Hrs. Chauffeur at	62½	$ 1.25
3 Hrs. Tapper at	"	$ 1.88
18 Hrs. Labor at	45	$ 8.10
Hrs. Labor at		$
1 Hrs. Compressor at	87½	$ 88
Compensation Ins.		$ 35
Trucking		$ 1 —
Builders Use of Water No patch (B.P.)		$
Tap by Hescell		$
		$
		$
		$
		$ 19.07

1 2 3 - 1938

~~St.~~ ~~Pl.~~ Lincoln Ave. No. 34

Name of Owner

Jack West

Labor and Mat'l. Report Sept 2 1938

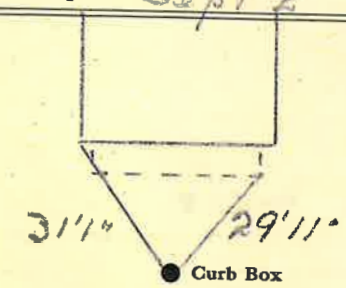

16 Main

Elev. of Main at tap 4½

Gate at

Gate at

TAX ID # 302.19-5-5

Curb Box

old Shutoff [illegible]