LABOR AND MATERIALS

1 Copper / ~~Lead~~	Connection 3/4	$ 1.23
1 Curb	Cock / ~~Valve~~ / ~~T. S. & V.~~ 3/4 in.	$ 1.68
1 Service Box Old returned	Short 3½x4½ / Long 4½x5½ / Buff. or Rdway	$ 1.75
37 Ft. 3/4 in.	Copper / Galv Iron / Cast Iron Pipe at 15	$ 5.55
____ Nipples	____ in. at ____	$ ____
____ Bushings	____ to ____ in. at ____	$ ____
____ Red'g / Inc'g Couplings	____ to ____ in. at ____	$ ____
____ Union	____ in. at ____	$ ____
____ Meter	____ in. at ____	$ ____
____ Lead Joints at		$ ____
____ Leadite Joints at		$ ____
____ Hrs. Foreman at		$ ____
2 Hrs. Chauffeur at	62½	$ 1.25
3 Hrs. Tapper at	~	$ 1.88
18 Hrs. Labor at	45	$ 8.10
____ Hrs. Labor at		$ ____
1 Hrs. Compressor at	87½	$ .88
____ Compensation Ins.		$ 35
____ Trucking		$ 1.—
____ Builders Use of Water	Hopatcong (BP)	$ ____
Temp by Hoosell		$ ____
		$ ____
		$ ____
		$ ____
		$ 22.67

1 2 4 - 1938

~~St.~~ ~~Pl.~~ Lincoln Ave. No. 35

Name of Owner

Leonis

Labor and Mat'l. Report Aug 27 1938

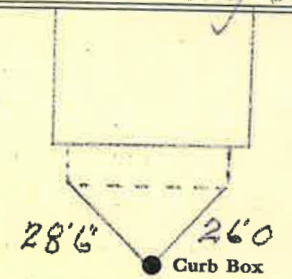

16 Main — Elev. of Main at tap 41

Gate at ● — ● Gate at

TAX ID # 302.15-11-15

● Curb Box

all Shut off