LABOR AND MATERIALS

1	Copper / ~~Lead~~ Connection	3/4	$ 1.23
1	Curb Cock / ~~Valve~~ / ~~T. S. & V.~~	3/4 in.	$ 1.68
1	Service Box Old returned Short 3½x4½ / ~~Long 4½x5½~~ / ~~Buff. or Rdway~~		$ 1.75
37	Ft. 3/4 in. Copper / ~~Galv Iron~~ / ~~Cast Iron~~ Pipe at		$ 5.55
	Nipples in. at		$
1	Bushings 3/4 to 1/2 in. at		$ .03
	Red'g / Inc'g Couplings to in. at		$
	Union in. at		$
	Meter in. at		$
	Lead Joints at		$
	Leadite Joints at		$
	Hrs. Foreman at		$
2	Hrs. Chauffeur at	62½	$ 1.25
3	Hrs. Tapper at	"	$ 1.88
18	Hrs. Labor at	45	$ 8.10
	Hrs. Labor at		$
	Hrs. Compressor at		$
	Compensation Ins.		$ .35
	Trucking		$ 1.00
	Builders Use of Water	no patch (B.P.)	$
	Tap by Hossell		$
			$
			$
			$
			$ 22.82

1 1 2 - 1938

~~St.~~ ~~Pl.~~

LINCOLN Ave. No. 3

Name of Owner

F. KEENAN

Labor and Mat'l. Report 8/26-38 19

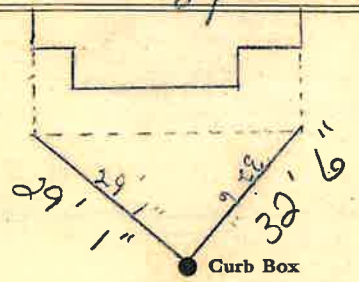

14 Main

Elev. of Main at tap 4'

Gate at ● ● Gate at

● Curb Box

Old Tap Shut Off