LABOR AND MATERIALS

1 Copper ~~Lead~~ } Connection 3/4 ..... $ 1.23

1 Curb { Cock ~~Valve~~ ~~T. S. & V.~~ } 3/4 in. ..... $ 1.68

1 Service Box Old returned { Short 3½x4½ ~~Long 4½x5½~~ ~~Buff. or Rdway~~ } ..... $ 1.75

33 Ft. 3/4 in. { Copper ~~Galv. Iron~~ ~~Cast Iron~~ } Pipe at 15 $ 4.95

..... Nipples ..... in. at ..... $ .....

..... Bushings ..... to ..... in. at ..... $ .....

..... Red'g Inc'g } Couplings ..... to ..... in. at ..... $ .....

..... Union ..... in. at ..... $ .....

..... Meter ..... in. at ..... $ .....

..... Lead Joints at ..... $ .....

..... Leadite Joints at ..... $ .....

..... Hrs. Foreman at ..... $ .....

1 Hrs. Chauffeur at 62½ $ 1.25

3 Hrs. Tapper at " $ 1.89

18 Hrs. Labor at .45 $ 8.10

..... Hrs. Labor at ..... $ .....

1 Hrs. Compressor at .87½ $ .88

..... Compensation Ins. ..... $ .35

..... Trucking ..... $ 1.—

..... Builders Use of Water (no gate NBP. $ .....

Tapby Hassell ..... $ .....

..... $ .....

..... $ .....

..... $ .....

$ 23.07

1 2 9 - 1938

~~St.~~ ~~Pl.~~ Lincoln Ave. No. 91

Name of Owner

Spaini

Labor and Mat'l. Report Aug 31 1938

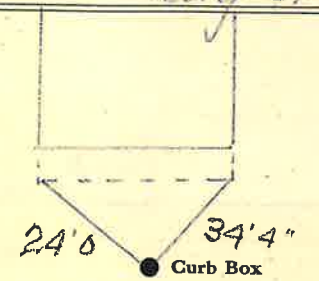

16 Main

Elev. of Main at tap 4½

Gate at ● 33' to MAIN

● Gate at

● Curb Box

old shutoff