Labor and Materials

Copper / Lead } Connection ..... $.....

Curb { Cock / Valve / T. S. & V. } ..... in ..... $.....

Service Box Old returned { Short 3½ x 4½ / Long 4½ x 5½ / Buff. or Rdway } ..... $.....

.....Ft. .....in. { Copper / Galv Iron / Cast Iron } Pipe at ..... $.....

..... Nipples .....in. at ..... $.....

.....Bushings .....to .....in. at ..... $.....

Red'g / Inc'g } Couplings .....to .....in. at ..... $.....

.....Union .....in. at ..... $.....

.....Meter .....in. at ..... $.....

.....Lead Joints at ..... $.....

.....Leadite Joints at ..... $.....

.....Hrs. Foreman at ..... $.....

.....Hrs. Chauffeur at ..... $.....

.....Hrs. Tapper at ..... $.....

.....Hrs. Labor at ..... $.....

.....Hrs. Labor at ..... $.....

.....Hrs. Compressor at ..... $.....

.....Compensation Ins. ..... $.....

.....Trucking ..... $.....

.....Builders Use of Water ..... $.....

..... $.....

..... $.....

..... $.....

..... $.....

$.....

Locust St. / Pl. / Ave. No. 12

Name of Owner

Lyons

Labor and Mat'l. Report 12-29 1919

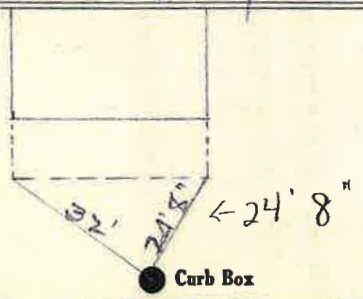

TAX ID # 303.17-20-2

.....Main Elev. of Main at tap .....

Gate at • • Gate at

• Curb Box