LABOR AND MATERIALS

1	Copper / Lead — Connection	1/2" x 3/4"	$ 2.71
1	Curb — Cock / Valve / T. S. & V.	3/4 in.	$ 3.83
1	Service box — Old returned — Short 3½ x 4½ / ~~Long 4½ x 5½~~ / ~~Buff or Rdway~~		$ 4.69
10	Ft. 3/4 in. — Copper / ~~G. I.~~ / ~~C. I.~~ — Pipe at 45		$ 4.50
	Nipples ____ in. at		$
	Bushings ____ to ____ in. at		$
	Red'g / Inc'g Coupl'gs ____ to ____ in. at		$
	Union ____ in. at		$
	Meter ____ in. at		$
	Lead Joints at		$
	Compound Joints at		$ 1.75
	Maintenance Foreman		$
	Hrs. Water Maint. Man—1 at		$ 24.75
	Hrs. Water Maint. Man—2 at		$
2	Hrs. Garage Foreman at	1.59	$ 3.18
19	Hrs. Labor— at	1.13	$ 21.47
	Hrs. Compressor at		$
	Compensation Ins. at $ 4.29 per C		$ 1.06
	Trucking		$ 1.50
	Pay't Patch		$ 7.20
Tap by Lareau 7-21-55			$
			$
			$
	O'head		$
			$ 50.14

St. Pl. Ave. No. 14

Logan

Name of Owner

Childs

Labor and Mat'l. Report July 21 1955

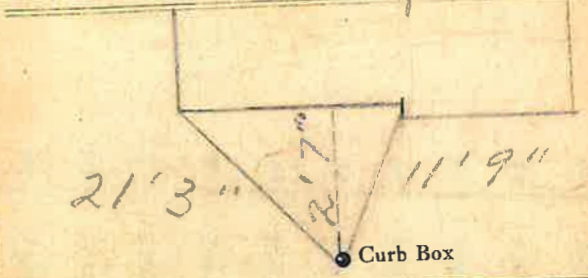

Ash Ave.

2" or 3" galv. Main

Elev. of Main at tap 4'

Gate at

Gate at

TAX ID # 302.16-3-11

Curb Box

Tap ON Ash Ave

L M—SC—2-1-54