LABOR AND MATERIALS

1 Copper ~~Lead~~ Connection 3/4		$ 1.31
1 Curb Cock ~~Valve~~ ~~T. S. & V.~~ 3/4 in.		$ 1.75
1 Service Box Old returned Short 3½x4½ ~~Long 4½x5½~~ ~~Buff. or Rdway~~		$ 1.60
35 Ft. 3/4 in. Copper ~~Galv Iron~~ ~~Cast Iron~~ Pipe at 18		$ 6.30
Nipples in. at		$
Bushings to in. at		$
Red'g Inc'g Couplings to in. at		$
Union in. at		$
Meter in. at		$
Lead Joints at		$
Leadite Joints at		$
Hrs. Foreman at		$
3 Hrs. Chauffeur at 62½		$ 1.87
Hrs. Tapper at		$
16 Hrs. Labor at		$ 7.20
Hrs. Labor at		$
Hrs. Compressor at		$
Compensation Ins.		$ 28
Trucking		$ 1.—
Builders Use of Water Patch		$ 5.—
Tap by Person		$
		$
		$
		$
		$ 26.31

29 - - 1940

St. 32 A-B
Pl.
Ave. No. 24+26

McDonald

Name of Owner

Neroni

Labor and Mat'l. Report June 1 1940

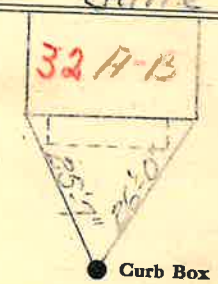

8"-1975

~~4~~" Main

Elev. of Main at tap 5

Gate at

Gate at

Curb Box