LABOR AND MATERIALS

1 Copper / ~~Lead~~ Connection 3/4" ..... $.....

1 Curb { ~~Cock~~ / ~~Valve~~ / ~~T. S. & V.~~ } 3/4 in. ..... $.....

1 Service box / ~~Old returned~~ { ~~Short 3½ x 4½~~ / Long 4½ x 5½ / ~~Buff or Rdway~~ } ..... $.....

12 Ft. 3/4 in. { Copper / ~~G. I.~~ / ~~C. I.~~ } Pipe at ..... $.....

..... Nipples ..... in. at ..... $.....

..... Bushings ..... to ..... in. at ..... $.....

..... Red'g / Inc'g Coupl'gs ..... to ..... in. at ..... $.....

..... Union ..... in. at ..... $.....

..... Meter ..... in. at ..... $.....

..... Lead Joints at ..... $.....

..... Compound Joints at ..... $.....

..... Maintenance Foreman ..... $.....

..... Hrs. Water Maint. Man—1 at ..... $.....

..... Hrs. Water Maint. Man—2 at ..... $.....

..... Hrs. Garage Foreman ..... at ..... $.....

..... Hrs. Labor— ..... at ..... $.....

..... Hrs. Compressor at ..... $.....

..... Compensation Ins. at $ ..... per C ..... $.....

..... Trucking ..... $.....

..... Pav't Patch ..... $.....

Tap by Lareau + Co. $.....

$.....

12-7-65. $.....

..... O'head ..... $.....

$.....

Dr.
~~St.~~
~~Pl.~~
McArthur ~~Ave.~~ No. 60

Name of Owner Kelly Bros.

Labor and Mat'l. Report Dec. 7, 1965

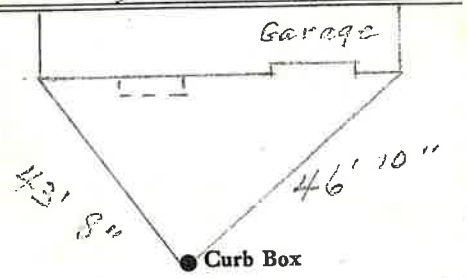

12" Main

Elev. of Main at tap 4½'

Gate at ●

● Gate at

● Curb Box

LSM—5C—3-10-61