LABOR AND MATERIALS

1	Copper / ~~Lead~~ Connection	3/4	$ 2.94
1	Curb — Cock / Valve / T. S. & V.	3/4 in.	$ 3.71
1	Service box — Old returned — Short 3½X4½ / Long 4½X5½ / Buff or Rdway		$ 5.90
21	Ft. 3/4 in. — Copper / G. I. / C. I. — Pipe at 30		$ 7.20
	Nipples ... in. at		$
	Bushings ... to ... in. at		$
	Red'g Inc'g Coupl'gs ... to ... in. at		$
	Union ... in. at		$
	Meter ... in. at		$
	Lead Joints at		$
	Compound Joints at		$
	Hrs. Water Maint. Man—1 at		$
4	Hrs. Water Maint. Man—2 at	91	$ 3.64
13	Hrs. Labor— ... at	80	$ 10.40
	Hrs. Labor— ... at		$
	Hrs. Compressor at		$
	Compensation Ins. at $ ... per C		$ 31
	Trucking		$ 1.00
	Pav't Patch		$
	Pay by Augusta		$
			$
			$
	O'head		$
			$ 35.10

48 #15

St. Pl. Ave. No. 407 86 McGirthen Drive

Name of Owner

C. Lyman

Labor and Mat'l. Report July 28 19 48

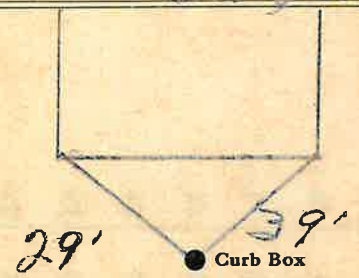

12 Main

Elev. of Main at tap 5

Gate at ● ● Gate at

● Curb Box

LSM-5C 5 15-48