LABOR AND MATERIALS

1	Copper / ~~Lead~~ Connection	3/4	$ 2.94
1	Curb { ~~Cock~~ / ~~Valve~~ / ~~T. S. & V.~~ }	3/4 in.	$ 3.71
1	Service box { Short 3½X4½ / Long 4½X5½ / Buff or Rdway } Old returned		$ 5.90
24	Ft. 3/4 in. { Copper / ~~G. I.~~ / ~~C. I.~~ } Pipe at 30		$ 7.20
	Nipples ... in. at		$
	Bushings ... to ... in. at		$
	Red'g Inc'g Coupl'gs ... to ... in. at		$
	Union ... in. at		$
	Meter ... in. at		$
	Lead Joints at		$
	Compound Joints at		$
7	Hrs. Water Maint. Man—1 at 1.01		$ 7.07
4	Hrs. Water Maint. Man—2 at 91.		$ 3.64
22	Hrs. Labor— ... at 80.		$ 17.60
	Hrs. Labor— ... at		$
	Hrs. Compressor at		$
	Compensation Ins. at $ ... per C		$ .62
	Trucking		$ 1.00
	Pav't Patch		$
Tap by Miller			$
			$
			$
	O'head		$
			$ 49.68

45 St.# 19

St. Pl. Ave. No. McArthur Blvd hist # 84

Name of Owner

Glynnan BARDIN SR

Labor and Mat'l. Report May 25 1948

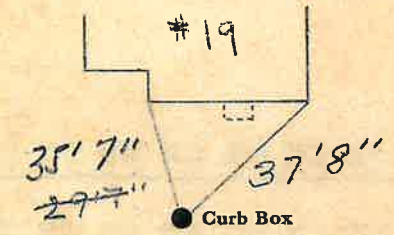

12 Main

Elev. of Main at tap 4

Gate at ● ● Gate at

● Curb Box

LSM-SC B 15-48