LABOR AND MATERIALS

1	Copper ~~Lead~~ Connection	3/4	$ 2.80
1	Curb { Clock / Valve / ~~T. S. & V.~~ }	3/4 in.	$ 3.60
1	Service box Old returned { ~~Short 3½X4½~~ / Long 4½X5½ / Buff or Rdway }		$ 5.90
12	Ft. 3/4 in. { Copper / Galv. Iron / Cast Iron }	Pipe at 35	$ 4.20
	Nipples ... in. at ...		$
	Bushings ... to ... in. at ...		$
	Red'g / Inc'g Couplings ... to ... in. at ...		$
	Union ... in. at ...		$
	Meter ... in. at ...		$
	Lead Joints at ...		$
	Compound Joints at ...		$
	Hrs. Foreman at ...		$
	Hrs. Chauffeur at ...		$
2	Hrs. Tapper at .82½r		$ 1.65
	Hrs. Labor at ...		$
	Hrs. Labor at ...		$
	Hrs. Compressor at ...		$
	Compensation Ins. 2.20		$ .03
	Trucking ...		$ 1.—
	Builders Use of Water ...		$ —
	Tap by Mogavero		$
			$
			$
			$

$ 19.18

Lot 12

St.
Pl.
Ave. No. 24

Name of Owner

Miss L E Brown

Labor and Mat'l. Report Oct 31 19 47

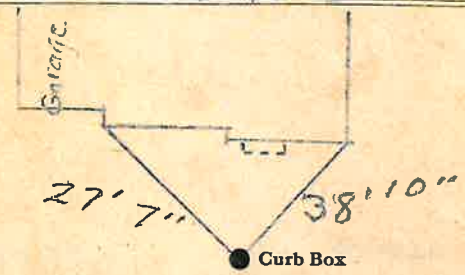

12 Main

Elev. of Main at tap 5'6"

Gate at ● ● Gate at

● Curb Box

LSM-5C-6-1-45