Labor and Materials

1	Copper ~~Lead~~ Connection	3/4	$ 1.46
1	Curb Cock ~~Valve~~ ~~T. S. & V.~~ in	3/4	$ 1.93
	Service Box ~~Old returned~~ Short 3½ x 4½ / Long 4½ x 5½ / Buff. ~~or Rdway~~		$ 1.77
14	Ft. in. Copper ~~Galv. Iron~~ ~~Cast Iron~~ Pipe at	3/4	$ 3.08
	Nipples in. at		$
	Bushings to in. at		$
	Red'g / Inc'g Conplings to in. at		$
	Union in. at		$
	Meter in. at		$
	Lead Joints at		$
	Leadite Joints at		$
2	Hrs. Foreman at	31¼	$ .63
4	Hrs. Chauffeur at	62½	$ 2.50
9	Hrs. Tapper at	62½	$ 5.62
9	Hrs. Labor at	45	$ 4.05
	Hrs. Labor at		$
2	Hrs. Compressor at	87½	$ 1.75
	Compensation Ins.		$ .39
	Trucking		$ 1.00
	Builders Use of Water	Patch	$ 5.00
			$
			$
			$
			$
			$ 29.18

6 -1937

9 Madinson St. ~~Pl.~~ ~~Aver~~ No. 9 15

Name of Owner

Parry

Labor and Mat'l. Report April 5 1937

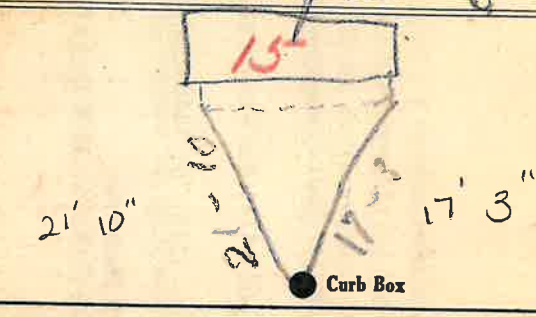

6" ~~4"~~ Main

Elev. of Main at tap 5'

Gate at

Gate at

Curb Box

old Shut off