LABOR AND MATERIALS

1 Copper Lead	Connection 3/4	$ 1.31
1 Curb { Cock Valve T. S. & V. }	3/4 in.	$ 1.75
1 Service Box Old returned { Short 3½x4½ Long 4½x5½ Buff. or Rdway }		$ 1.60
11 10 Ft. 3/4 in. { Copper Galv Iron Cast Iron }	Pipe at 18	$ 1.80
Nipples	in. at	$
Bushings	to in. at	$
1 Red'g Inc'g	Couplings Cop. to Cop. in. at	$
Union	in. at	$
Meter	in. at	$
Lead Joints at		$
Leadite Joints at		$
Hrs. Foreman at		$
7 Hrs. Chauffeur at	62½	$ 4.37
7 Hrs. Tapper at		$ 4.38
Hrs. Labor at		$
Hrs. Labor at		$
Hrs. Compressor at		$
Compensation Ins.		$ .27
Trucking		$ 1.—
Builders Use of Water	Patch	$ .50
Tap for House		$
26 ft 3/4 Pipe to House		$ —
		$
		$ 21.48

APR 5 - - 1940

St. 32
Pl.
Madison Ave. No. 24

Name of Owner

McLaughlin

Labor and Mat'l. Report Apr 26 19

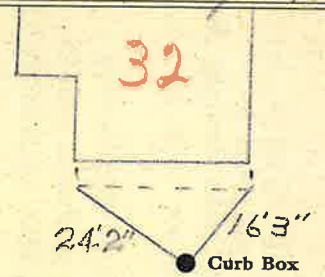

6"
4" Main

Elev. of Main at tap 5'

Gate at ● ● Gate at

● Curb Box

To be billed - JH