Labor and Materials

1	Copper / ~~Lead~~ Connection	3/4	$ 1.48
1	Curb { Cock / ~~Valve~~ / ~~T.S.& V.~~ } in	3/4	$ 1.79
1	Service Box { Short 3½x4½ / ~~Long 4½x5½~~ / ~~Buff. or Edwar~~ } Old returned		$ 1.18
12	Ft. in. { Copper / ~~Galv. Iron~~ / ~~Cast Iron~~ } Pipe at		$ 2.16
	Nipples in. at		$
	Bushings to in. at		$
	Red'g / Inc'g Couplings to in. at		$
	Union in. at		$
	Meter in. at		$
	Lbs. Br. Stone at		$
	Lbs. Sand at		$
	Bags Cement at		$
	Paving Brick { Mack / Red / Asphalt } at		$
	Lead Joints at		$
	Leadite Joints at		$
4	Hrs. Foreman at		$ 2.50
10	Hrs. Common Labor at		$ 4.50
	Hrs. Common Labor at		$
	Hrs. Mason at		$
	Hrs. Masons Helper at		$
	Hrs. Compressor at		$
	Compensation Ins		$ .22
	Trucking		$ 1.—
	Builders Use of Water Rated		$ .5—
		Total	$ 19.83

5 11

Labor and Material Report May 10 1932

7 Madison ST

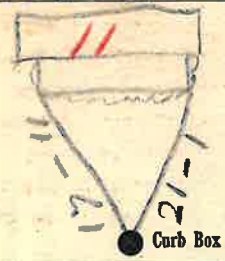

X 6" Main

Elev. of Main at tap 4½

Gate at ● ● Gate at

● Curb Box

New Tap of water from #5 Madison St old

OK 6/6/5