Labor and Materials

1	Copper Lead — Connection	3/4"	$ 2.76
1	Curb — Cock ~~Valve~~ ~~T. S. & V.~~	3/4 in	$ 3.49
1	Service Box Old returned — Short 3½ x 4½ ~~Long 4½ x 5½~~ ~~Buff. or Rdway~~		$ 4.74
22 Ft. 3/4 in.	~~Copper~~ ~~Galv Iron~~ ~~Cast Iron~~ Pipe at 38		$ 8.36
	Nipples in. at		$
	Bushings to in. at		$
	Red'g Inc'g — Couplings to in. at		$
	Union in. at		$
	Meter in. at		$
	Lead Joints at		$
	Leadite Joints at		$
	Hrs. Foreman at		$
8	Hrs. ~~Chauffeur~~ at	MM-2 1.24	$ 9.92
	Hrs. Tapper at		$ 15.08
16	Hrs. Labor at	1.13	$
	Hrs. Labor at		$
	Hrs. Compressor at		$
	Compensation Ins.	4.406	$ 1.23
	Trucking		$ 1.00
	Builders Use of Water		$
Tap by Gissal 4-17-53			11.20
			$
			$
			$
			$ 69.75

49.58

St. ~~Pl.~~ Ave. No. 115

Maple

Name of Owner Colb

Labor and Mat'l. Report April 17 1953

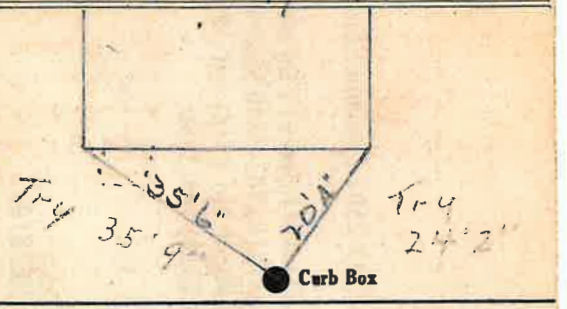

6" Main — Elev. of Main at tap 5'

Gate at • — • Gate at

TAX ID # 303.17-17-6

● Curb Box