Labor and Materials

	~~Lead~~ Connection	3/4	$
1	Curb Cock	3/4	$
1	Service Box Old returned { Short 3½ x 4½ / ~~Long 4½ x 6½~~ / ~~Portable~~ }		$
8	Ft. 3/4 in. ~~G.I.~~ CoP Pipe at		$
	Nipples in. at		$
1	Bushings 3/4 to 1/2 in. at		$
	Red'g Coup to in. at		$
	Inc'g Coup to in. at		$
	Union in. at		$
	Meter in. at		$
600	Cu. Yds. Br. Stone at		$
1.00	Cu. Yds. Sand at		$
2	Bags Cement at		$
85	Paving Brick { Mack / ~~Red~~ / Asphalt } at		$
2	Hrs. Foreman at		$
10	Hrs. Common Labor at		$
4	Hrs. Mason at		$
4	Hrs. Helpers at		$
	Hrs. at		$
ND	Builders' Use of Water		$
	at		$
1	hrs. compressor at		$
	at		$
	at		$
	Total		$ 24.65

Labor and Material Report Aug. 20 1925

13648 Maple St.

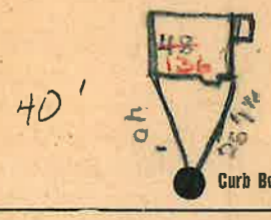

6" Main

Elev. of Main at tap 4½

Gate at ● ● Gate at

● Curb Box

TAX ID # 303.17-10-26

LABOR AND MATERIALS

_____ Copper / Lead } Connection _____ $_____

_____ Curb } Cock / Valve / T.S. & V. } _____ in. _____ $_____

_____ Service box / Old returned { Short 3-1/2 x 4-1/2 / Long 4-1/2 x 5-1/2 } _____ $_____

_____ Ft. ____ in. { Copper / G.I. / C.I. } Pipe at _____ $_____

_____ Nipples _____ in. at _____ $_____

_____ Bushings _____ to _____ in. at _____ $_____

_____ Red'g

_____ Inc'g

_____ Union _____ in. at _____ $_____

_____ Meter _____ in. at _____ $_____

_____ _____ $_____

_____ Compound Joints at _____ $_____

_____ Maintenance Foreman _____ $_____

_____ Hrs. Water Maint. Man - 1 at _____ $_____

_____ Hrs. Water Maint. Man - 2 at _____ $_____

_____ Hrs. Garage Foreman _____ at _____ $_____

_____ Hrs. Labor _____ at _____ $_____

_____ Hrs. Compressor at _____ $_____

_____ _____ $_____

_____ Trucking _____ $_____

_____ Pav't Patch _____ $_____

_____ _____ $_____

_____ _____ $_____

_____ _____ $_____

_____ _____ $_____

$_____

MAPLE St. / Ave. No. 136

Name of Owner

Labor and Mat'l. Report ~~10~~ 6-2013

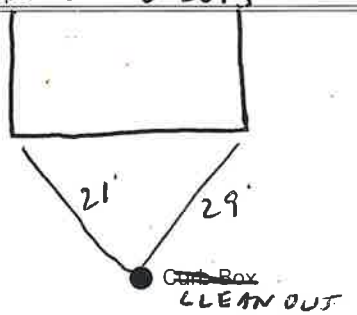

_____ Main

Elev. of Main at tap _____

Gate at ●

● Gate at

_____ _____

● Curb Box