LABOR AND MATERIALS

1 ~~Copper~~ Lead } Connection 3/4 $ ____

1 Curb { ~~Cock~~ ~~Valve~~ ~~T. S. & V.~~ } 1 in. $ ____

1 Service box { ~~Short 3½ x 4½~~ ~~Long 4½ x 5½~~ ~~Buff or Rdway~~ } ~~Old returned~~ $ ____

21 Ft. 1 in. { ~~Copper~~ ~~G. I.~~ ~~C. I.~~ } Pipe at $ ____

____ Nipples ____ in. at ____ $ ____

____ Bushings ____ to ____ in. at ____ $ ____

____ Red'g / Inc'g Coupl'gs ____ to ____ in. at ____ $ ____

____ Union ____ in. at ____ $ ____

____ Meter ____ in. at ____ $ ____

____ Lead Joints at ____ $ ____

____ Compound Joints at ____ $ ____

2 Maintenance Foreman ____ $ ____

2 Hrs. Water Maint. Man—1 at ____ $ ____

2 Hrs. Water Maint. Man—2 at ____ $ ____

____ Hrs. Garage Foreman ____ at ____ $ ____

8 Hrs. Labor— ____ at ____ $ ____

____ Hrs. Compressor at ____ $ ____

____ Compensation Ins. at $ ____ per C ____ $ ____

____ Trucking 1 00 $ ____

1 Pav't Patch ____ $ ____

____ $ ____

____ $ ____

____ $ ____

____ O'head ____ $ ____

$ 28.57

479

St. / Pl. / Ave. Maple No. 139

Name of Owner

Linehan

Labor and Mat'l. Report May 22 1925

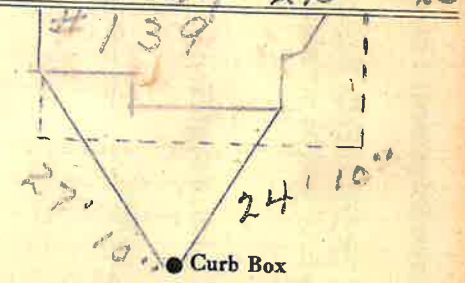

6" Main

Elev. of Main at tap 5'

Gate at ●

● Gate at

● Curb Box

LSM—5C—2-5 56