LABOR AND MATERIALS

1	Copper / ~~Lead~~ Connection	3/4	$ 1.79
1	Curb { Clock Valve / T. S. & V. }	3/4 in.	$ 2.61
	Service box / Old returned { Short 3½X4½ / Long 4½X5½ / Buff or Rdway }	3 ones	—
3'	Ft. 3/4 in. { Copper / ~~Galv. Iron~~ / ~~Cast Iron~~ }	Pipe at 23	$ 7.13
	Nipples	in. at	$
	Bushings	to in. at	$
	Red'g / Inc'g Couplings	to in. at	$
	Union	in. at	$
	Meter	in. at	$
	Lead Joints at		$
	Compound Joints at		$
1	Hrs. ~~Foreman at~~ WWM	92½	$ 9.30
		82½	$ 5.77
7	Hrs. Chauffeur at		$
	Hrs. Tapper at	71½	$ 13.59
19	Hrs. Labor at		$
	Hrs. Labor at	87½	$ 1.75
2	Hrs. Compressor at		$ .56
	Compensation Ins.		$ 1.00
	Trucking		$ 5.00
	Builders Use of Water		$
Tapy Warsinski			$
			$
			$
			$ 40.13

✓

✓

St. ~~Pl.~~ ~~Ave.~~ No. 156 Maple

Name of Owner

Foley

Labor and Mat'l. Report Aug 20 1946

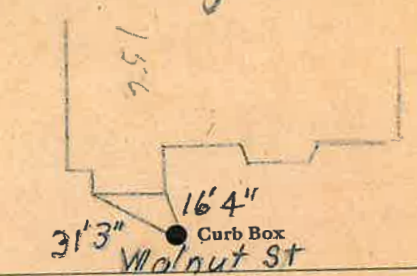

4 Main

Elev. of Main at tap 5

Gate at ● ● Gate at

TAX ID # 303.17-11-31

● Curb Box

Foley Tavern,

