LABOR AND MATERIALS

1	Copper / ~~Lead~~ Connection	3/4	$ 1.79
1	Curb { Clock / Valve / T. S. & V. }	3/4 in.	$ 2.61
1	Service box Old returned { Short 3½X4½ / ~~Long 4½X5½~~ / Buff or Rdway }		$ 1.82
10 Ft.	3/4 in. { Copper / Galv. Iron / Cast Iron } Pipe at 23		$ 2.30
	Nipples ..... in. at		$
	Bushings ..... to ..... in. at		$
	Red'g / Inc'g Couplings ..... to ..... in. at		$
	Union ..... in. at		$
	Meter ..... in. at		$
	Lead Joints at		$
	Compound Joints at		$
	Hrs. Foreman at		$
6	Hrs. Chauffeur at	82½	$ 4.95
	Hrs. Tapper at		$
22	Hrs. Labor at	71½	$ 15.73
	Hrs. Labor at		$
2	Hrs. Compressor at	87½	$ 1.75
	Compensation Ins.		$ .57
	Trucking		$ 1.00
	Builders Use of Water.	2	$ 9.00
	Tap by Warrington		$
			$
			$
			$
			$ 41.57

✓

11-7 46

St. / ~~Pl.~~ / ~~Ave.~~ No. Maple 198

Name of Owner

Kennedy

Labor and Mat'l. Report Aug 6 1946

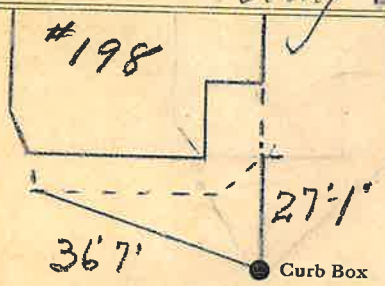

6 Main

Elev. of Main at tap 6

Gate at ● ● Gate at

● Curb Box

SHUT OFF @ curb 10-25-99

RAZED

LSM-5C-6-1-45