Labor and Materials

1	Copper ~~Lead~~ Connection	3/4"	$ 2.41
1	Curb Cock / ~~Valve~~ / ~~T. S. & V.~~	3/4 in	$ 3.41
Same	Service Box Old returned ~~Short 3½ x 4½~~ / Long 4½ x 5½ / ~~Buff. or Rdway~~		$ —
9	Ft. ~~3/4~~ in. Copper / ~~Galv Iron~~ / ~~Cast Iron~~ Pipe at	40	$ 3.60
	Nipples in. at		$
	Bushings to in. at		$
	Red'g / Inc'g Couplings to in. at		$
	Union in. at		$
	Meter in. at		$
	Lead Joints at		$
	Leadite Joints at		$ 1.50
	Hrs. Foreman at		$ 2.80
	Hrs. Chauffeur at		$
13	Hrs. ~~Tapper~~ at M.M.2.	1.24	$ 16.12
11	Hrs. Labor at	1.13	$ 12.43
	Hrs. Labor at		$
2	Hrs. Compressor at	1.50	$ 3.00
	Compensation Ins.	3 % 1	$ 1.10
	Trucking		$ 1.50
	Builders Use of Water	.56	$ 8.96
	Cap to Iron Adapter	3/4	$ .60
			$
			$
			$
		44.17	$ 53.13

Tap by Gifford
3-15-54.

6-54

St. ~~Pl.~~ Maple Ave. No. 206

Name of Owner
Alden & Hinson.

Labor and Mat'l. Report Mar. 15 1954

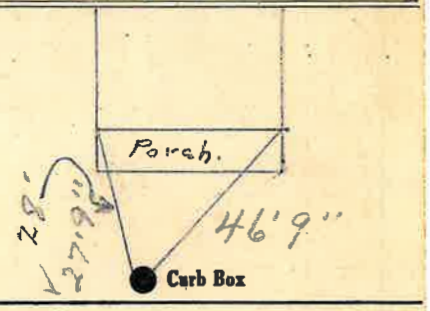

6" Main

Elev. of Main at tap 6'

Gate at •

• Gate at

• Curb Box

TAX ID # 303.17-14-14