57-47

Mason St. Pl. Ave. No. 14

Name of Owner

hangsing

Labor and Mat'l. Report July 22 1947

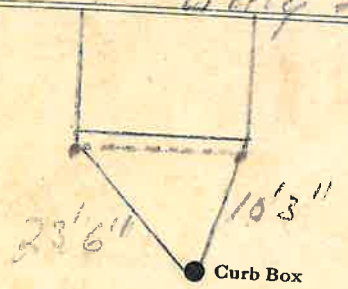

4 Main

Elev. of Main at tap 4'

Gate at ●

● Gate at

● Curb Box

LSM-5C-6-1-45

LABOR AND MATERIALS

1	Copper Lead } Connection 3/4	$ 2.80
1	Curb { Clock Valve T. S. & V. } 3/4 in.	$ 3.60
1	Service box Old returned { Short 3½X4½ Long 4½X5½ Buff or Rdway }	$ 5.90
19 Ft. 3/4 in.	{ Copper Galv. Iron Cast Iron } Pipe at 35	$ 6.65
	Nipples in. at	$
	Bushings to in. at	$
	Red'g Inc'g } Couplings to in. at	$
	Union in. at	$
	Meter in. at	$
	Lead Joints at	$
	Compound Joints at	$
2	Hrs. Foreman at	$ 2.02
2	Hrs. Chauffeur at	$ 1.82
	Hrs. Tapper at	$
15	Hrs. Labor at	$ 12.00
	Hrs. Labor at	$
	Hrs. Compressor at	$
	Compensation Ins.	$ .35
	Trucking	$ 1.—
	Builders Use of Water.	$
Tap & Miller		$
		$
		$
		$
		$ 26.04