LABOR AND MATERIALS

1	Copper Lead	Connection 3/4	$ 2.80
1	Curb (Clock Valve T. S. & V.)	3/4 in.	$ 3.60
1	Service box Old returned	(Short 3½X4½ Long 4½X5½ Buff or Rdway)	$ 5.80
18 Ft.	3/4 in.	(Copper Galv. Iron Cast Iron) Pipe at 35	$ 6.30
	Nipples	in. at	$
	Bushings	to in. at	$
	Red'g Inc'g Couplings	to in. at	$
	Union	in. at	$
	Meter	in. at	$
	Lead Joints at		$
	Compound Joints at		$
2	Hrs. Foreman at		$ 2.02
2	Hrs. Chauffeur at		$ 1.82
	Hrs. Tapper at		$
15	Hrs. Labor at		$ 12.00
	Hrs. Labor at		$
	Hrs. Compressor at		$
	Compensation Ins.		$ 35
	Trucking		$ 1.—
	Builders Use of Water		$
Taps by Miller			$
			$
			$
			$ 35.69

52/47

St.
~~Pl.~~
Ave. No. 16

Mason

Name of Owner

Efflandt

Labor and Mat'l. Report July 28 19 47

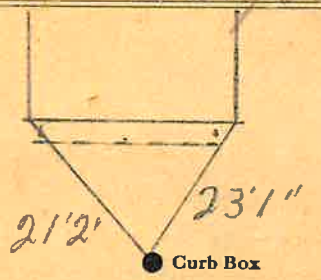

1 Main

Elev. of Main at tap 4½

Gate at ●

● Gate at

● Curb Box

L9M-5C-6-1-45