LABOR AND MATERIALS

1	Copper ~~Lead~~ Connection	3/4	$ 2.80
1	Curb {Clock ~~Valve~~ ~~T. S. & V.~~}	3/4 in.	$ 3.60
1	Service box Old returned {Short 3½X4½ ~~Long 4½X5½~~ ~~Buff or Rdway~~}		$ 5.80
16	Ft. 3/4 in. {Copper ~~Galv. Iron~~ ~~Cast Iron~~}	Pipe at	$ 6.30
	Nipples ... in. at		$
	Bushings ... to ... in. at		$
	Red'g Inc'g Couplings ... to ... in. at		$
	Union ... in. at		$
	Meter ... in. at		$
	Lead Joints at		$
	Compound Joints at		$
2	Hrs. Foreman at		$ 2.02
2	Hrs. Chauffeur at		$ 1.82
	Hrs. Tapper at		$
15	Hrs. Labor at		$ 12.00
	Hrs. Labor at		$
	Hrs. Compressor at		$
	Compensation Ins.		$ .35
	Trucking		$ 1.00
	Builders Use of Water		$
	Tap by Miller		$
			$
			$
			$
			$ 35.69

66/47

St.
Mason Pl.
Ave. No. 18

Name of Owner
Roberts

Labor and Mat'l. Report July 28 1947

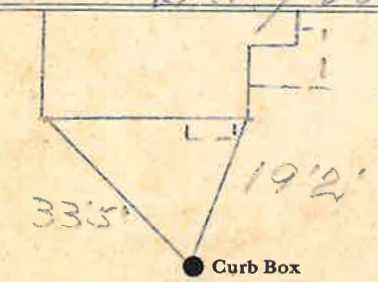

4 Main

Elev. of Main at tap 4½

Gate at ● ● Gate at

TAX ID # 302.12-16-15

● Curb Box

LBM-5C-6-1-45