LABOR AND MATERIALS

1 Copper ~~Lead~~ } Connection 3/4 ..... $.....

1 Curb { Clock ~~Valve~~ ~~T. S. & V.~~ } 3/4 in. ..... $.....

1 Service box Old returned { Short 3½X4½ ~~Long 4½X5½~~ Buff or Rdway } ..... $.....

7 Ft. 3/4 in. { Copper ~~Galv. Iron~~ ~~Cast Iron~~ } Pipe at ..... $.....

..... Nipples ..... in. at ..... $.....

..... Bushings ..... to ..... in. at ..... $.....

..... Red'g Inc'g } Couplings ..... to ..... in. at ..... $.....

..... Union ..... in. at ..... $.....

..... Meter ..... in. at ..... $.....

..... Lead Joints at ..... $.....

..... Compound Joints at ..... $.....

..... Hrs. Foreman at ..... $.....

..... Hrs. Chauffeur at ..... $.....

..... Hrs. Tapper at ..... $.....

11 Hrs. Labor at ..... $.....

..... Hrs. Labor at ..... $.....

..... Hrs. Compressor at ..... $.....

..... Compensation Ins. ..... $.....

..... Trucking ..... $.....

..... Builders Use of Water ..... $.....

..... $.....

..... $.....

..... $.....

..... $.....

$ 15.92

St. 25
Pl.
Ave. No. 19

Mason

Name of Owner

Labor and Mat'l. Report Sept 25 1925

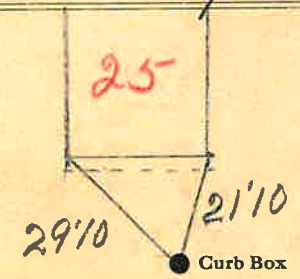

4 Main

Elev. of Main at tap 6"

Gate at ● ● Gate at

● Curb Box

Tax ID # 302.12-19-1

LSM-5C-6-1-45