LABOR AND MATERIALS

1	Copper / ~~Lead~~ Connection 3/4	$ 2.80
1	Curb { Clock / ~~Valve~~ / ~~T. S. & V.~~ } 3/4 in.	$ 3.60
1	Service box / Old returned { Short 3⅛X4⅛ / ~~Long 4⅛X5⅛~~ / ~~Buff or Rdway~~ }	$ 5.80
19 Ft. 3/4 in.	{ Copper / ~~Galv. Iron~~ / ~~Cast Iron~~ } Pipe at	$ 6.65
	Nipples in. at	$
	Bushings to in. at	$
	Red'g / Inc'g Couplings to in. at	$
	Union in. at	$
	Meter in. at	$
	Lead Joints at	$
	Compound Joints at	$
2	Hrs. Foreman at	$ 2.02
2	Hrs. Chauffeur at	$ 1.82
	Hrs. Tapper at	$ 12.00
15	Hrs. Labor at	$
	Hrs. Labor at	$
	Hrs. Compressor at	$
	Compensation Ins.	$ .35
	Trucking	$ 1.00
	Builders Use of Water	$
Tap & Miller		$
		$
		$
		$ 36.04

74-147

St. / ~~Pl.~~ / Ave. No. 26

Mason

Name of Owner

Goodell

Labor and Mat'l. Report July 26 1947

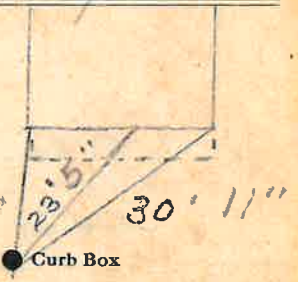

1 Main

Elev. of Main at tap 4'

Gate at ●

● Gate at

● Curb Box

Tax ID # 302.12-16-19

LSM-5C-6-1-45