LABOR AND MATERIALS

1	Copper ~~Lead~~ Connection	3/4	$ 2.80
1	Curb { Clock ~~Valve~~ ~~T. S. & V.~~ }	3/4 in.	$ 3.60
1	Service box Old returned { Short 3½X4½ ~~Long 4½X5½~~ ~~Buff or Rdway~~ }		$ 5.80
18	Ft. 3/4 in. { Copper ~~Galv. Iron~~ ~~Cast Iron~~ }	Pipe at 35	$ 6.30
	Nipples ..... in. at		$
	Bushings ..... to ..... in. at		$
	Red'g Inc'g } Couplings ..... to ..... in. at		$
	Union ..... in. at		$
	Meter ..... in. at		$
	Lead Joints at		$
	Compound Joints at		$
2	Hrs. Foreman at		$ 2.02
2	Hrs. Chauffeur at		$ 1.82
1	Hrs. Tapper at		$
15	Hrs. Labor at		$ 12.00
	Hrs. Labor at		$
	Hrs. Compressor at		$
	Compensation Ins.		$ .35
	Trucking		$ 1.—
	Builders Use of Water.		$ —
			$
			$
			$
			$
			$ 35.69

54-147

Mag ram St. Pl. Ave. No. 30

Name of Owner

Magram

Labor and Mat'l. Report July 22 1947

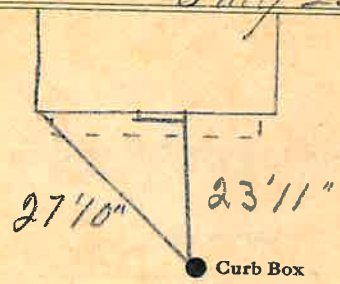

4 Main

Elev. of Main at tap 4½

Gate at ● ● Gate at

● Curb Box

Tax ID # 302.12-16-21

LSM-5C-6-1-45